VANQUISH PROJECTS

Accommodation Schedule

-	--
-	--
-	--
-	--
-	--
-	--
-	--
-	--
-	--
-	--
-	--
-	--
-	--
-	**Total Working Positions**
--sqft	**Total Area**

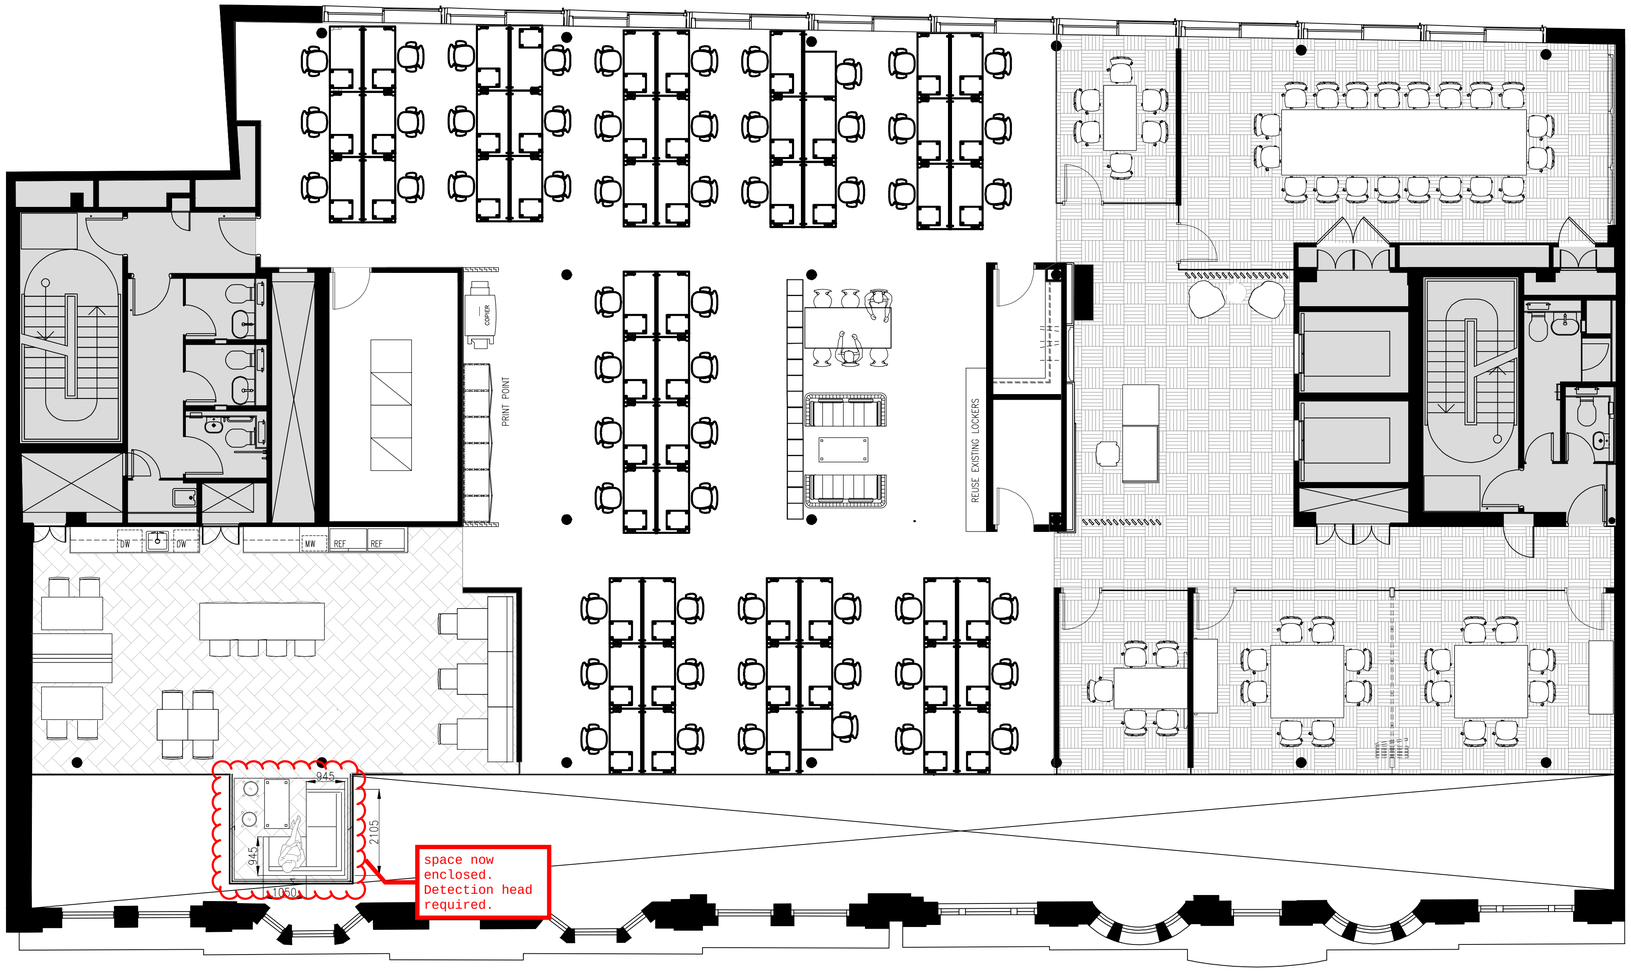

Floor 03

KEY TO GENERAL ARRANGEMENT DETAILS

Keys not to scale . Some symbols shown might not appear on the drawing

- Existing structural basebuild wall
- Existing partition
- New 75mm solid stud partition (Single skin)
- New 100mm solid stud partition (Single skin)
- New 100mm solid stud partition (Double skin)
- New half height partition
- New partition(Detail t.b.c.)

Note:- All partitions to be 'raised floor to underside of suspended ceiling' – Unless otherwise noted (See below)

GLAZING DETAILS

- Existing silicon glass
- Existing glazed module
- New single glazed silicon glass
- New double glazed silicon glass
- New single glazed module
- New double glazed module

DOOR DETAILS

- Existing door — EX1-01 EX1=Existing 1st floor; RX1-01 RX1=Relocated 1st floor; N1-01 N1 = New 1st floor
- New solid framed door — VP= Vision Panel; SEC= Security door; FD20S= Fire door rated with smoke seal
- New glass door — FD20S= 20min; FD30S= 30min; FD60S= 60min

All doors to be full height unless otherwise stated

R1-01 R1 = 1st floor room 01 = Room no. W1-01 W1 = 1st floor window 01 = Window no.

- Ex — Existing furniture
- New furniture
- Expansion furniture
- Low height (Tambour unit)
- Medium height (Drawer unit)
- High height (Door unit)
- General Storagewall
- Cloaks Storagewall
- Filing Cabinet
- Landlord Area – No works

REV	DESCRIPTION	BY	DATE
G	Drawing updated - Sofa size	CJ	09/09/2020
F	Drawing updated - Reception Desk	LP	24/08/2020
E	Drawing updated - Meeting tables updated	LP	19/08/2020
D	Drawing updated	CJ	18/08/2020
C	Drawing updated - Furniture updates	CJ/ES	04/08/2020
B	Drawing updated - phone booths tpoint	CJ	27/07/2020
A	Drawing updated	CJ	15/07/2020
-	Drawing first produced	CJ	07/07/2020

DRAWING STATUS
PRE CONSTRUCTION

Davidson Building

Address
5 Southampton Street
Covent Garden, London
WC2E 7HA

Project Number	Ref	Floor	Detail
10355	01	03	GA

Drawing Title
Third Floor - General Arrangement

Produced by	Scale	Amended date	Rev
CJ	1:75@A1	09/09/2020	G

VANQUISH PROJECTS
324 Metal Box Factory
30 Great Guildford Street
London SE1 0HS

VANQUISH PROJECTS

© VANQUISH PROJECTS Property & Copyright
Use of drawings is not permitted nor can they be copied, duplicated or distributed without the consent of VANQUISH PROJECTS.

All designs are the sole property of VANQUISH PROJECTS, and may not be used, transferred, or disclosed to a third party without the express permission of VANQUISH PROJECTS Electronic copies of this drawing are supplied for convenience only. No dimensions or other information should be used from the electronic copy. Do not scale from this drawing. Figured dimensions only are to be used 'For Construction' and any scaling of the drawing will be at the Contractor's risk. Contractor to verify all dimensions, levels, and components on-site. Any discrepancies shall be addressed in writing to this office for clarification prior to the commencement of the work, otherwise the Contractor shall bear full responsibility for any associated cost. Any claims for variations or extras shall be submitted to this office for assessment prior to approval of any such variation or extra. This drawing is to be read in conjunction with all other Contract documentation. This drawing must be signed otherwise it will be invalid. Building parameters taken from as built drawings provided. Check survey undertaken only, subject to statutory approval. All dimensions shown are in millimetres unless otherwise shown.